McDOUGALL UNITED CHURCH
LOWER LEVEL PROPOSED FLOOR PLAN

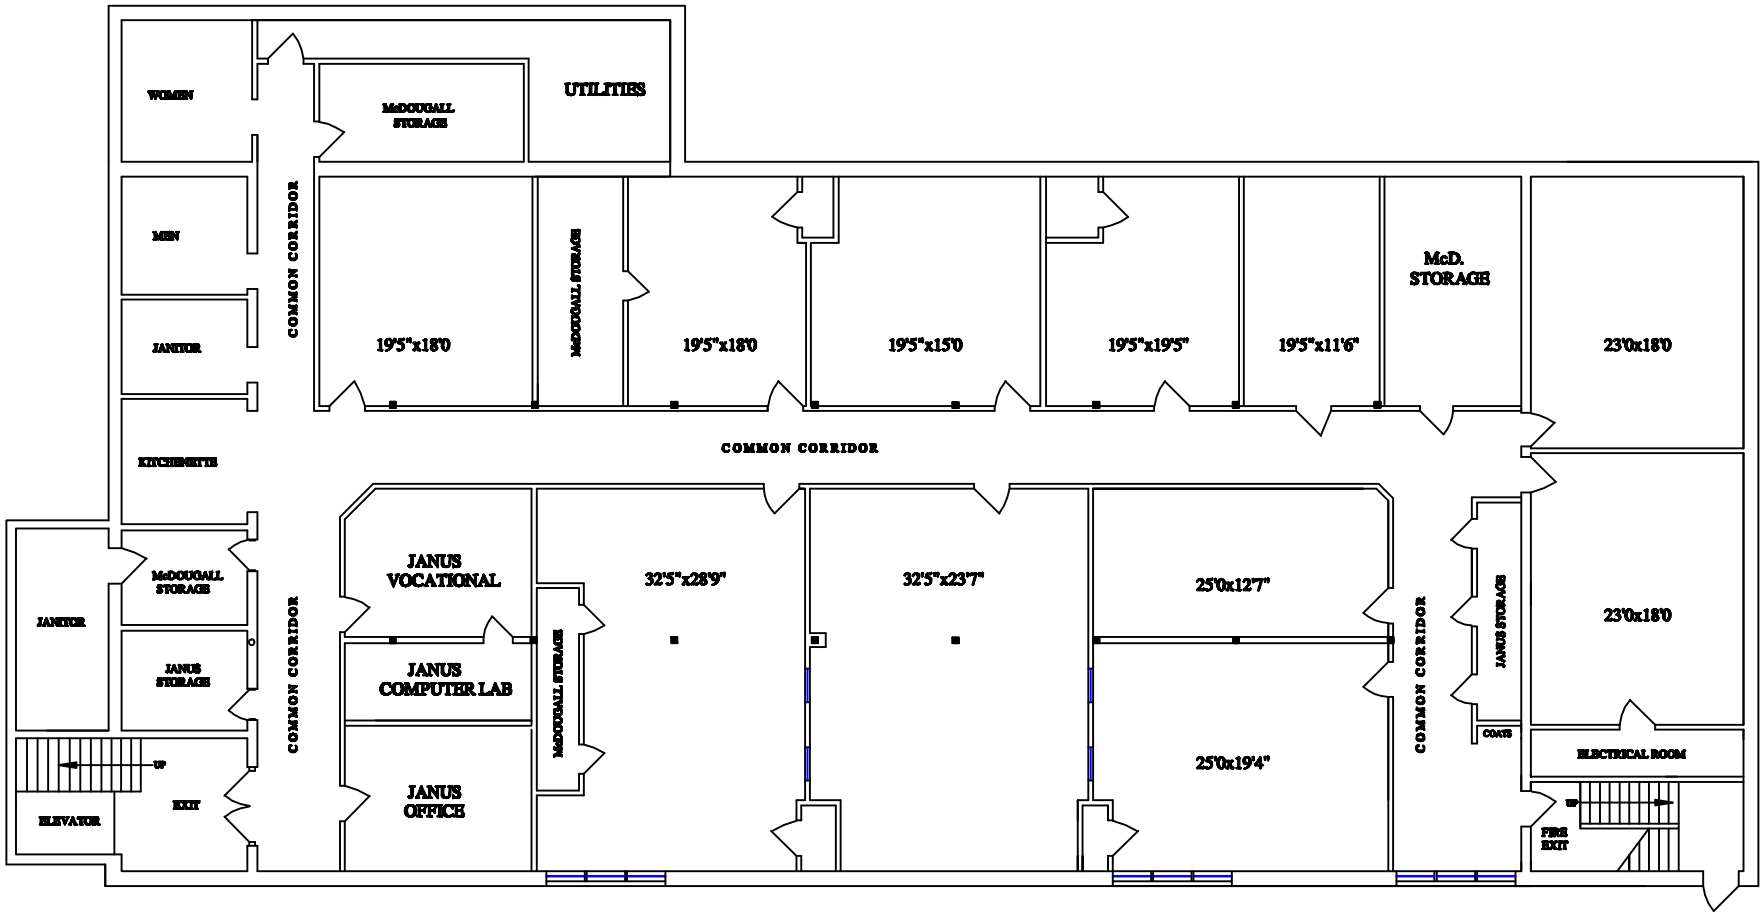

AS BUILT DEC.10, 2007 JOY PLETT
REVISED TO ADD SPACES FEBRUARY 2008
AS-BUILT REVISED MAY 21, 2008